

EXHIBIT #2

LEGEND



4FTX12FT
CONFERENCE
TABLE



36 INCH ROUND
TABLE WITH QUEEN
ANNE BASE



CONFERENCE
CREDENZA 72 INCH




JUDGE'S TUFTED
TASK CHAIR




JUDGE'S NON
TUFTED GUEST
CHAIR



2 DRAWER LATERAL
FILE

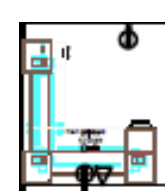

L SHAPED
HEIGHT
ADJUSTABLE
DESK WITH
PEDESTALS

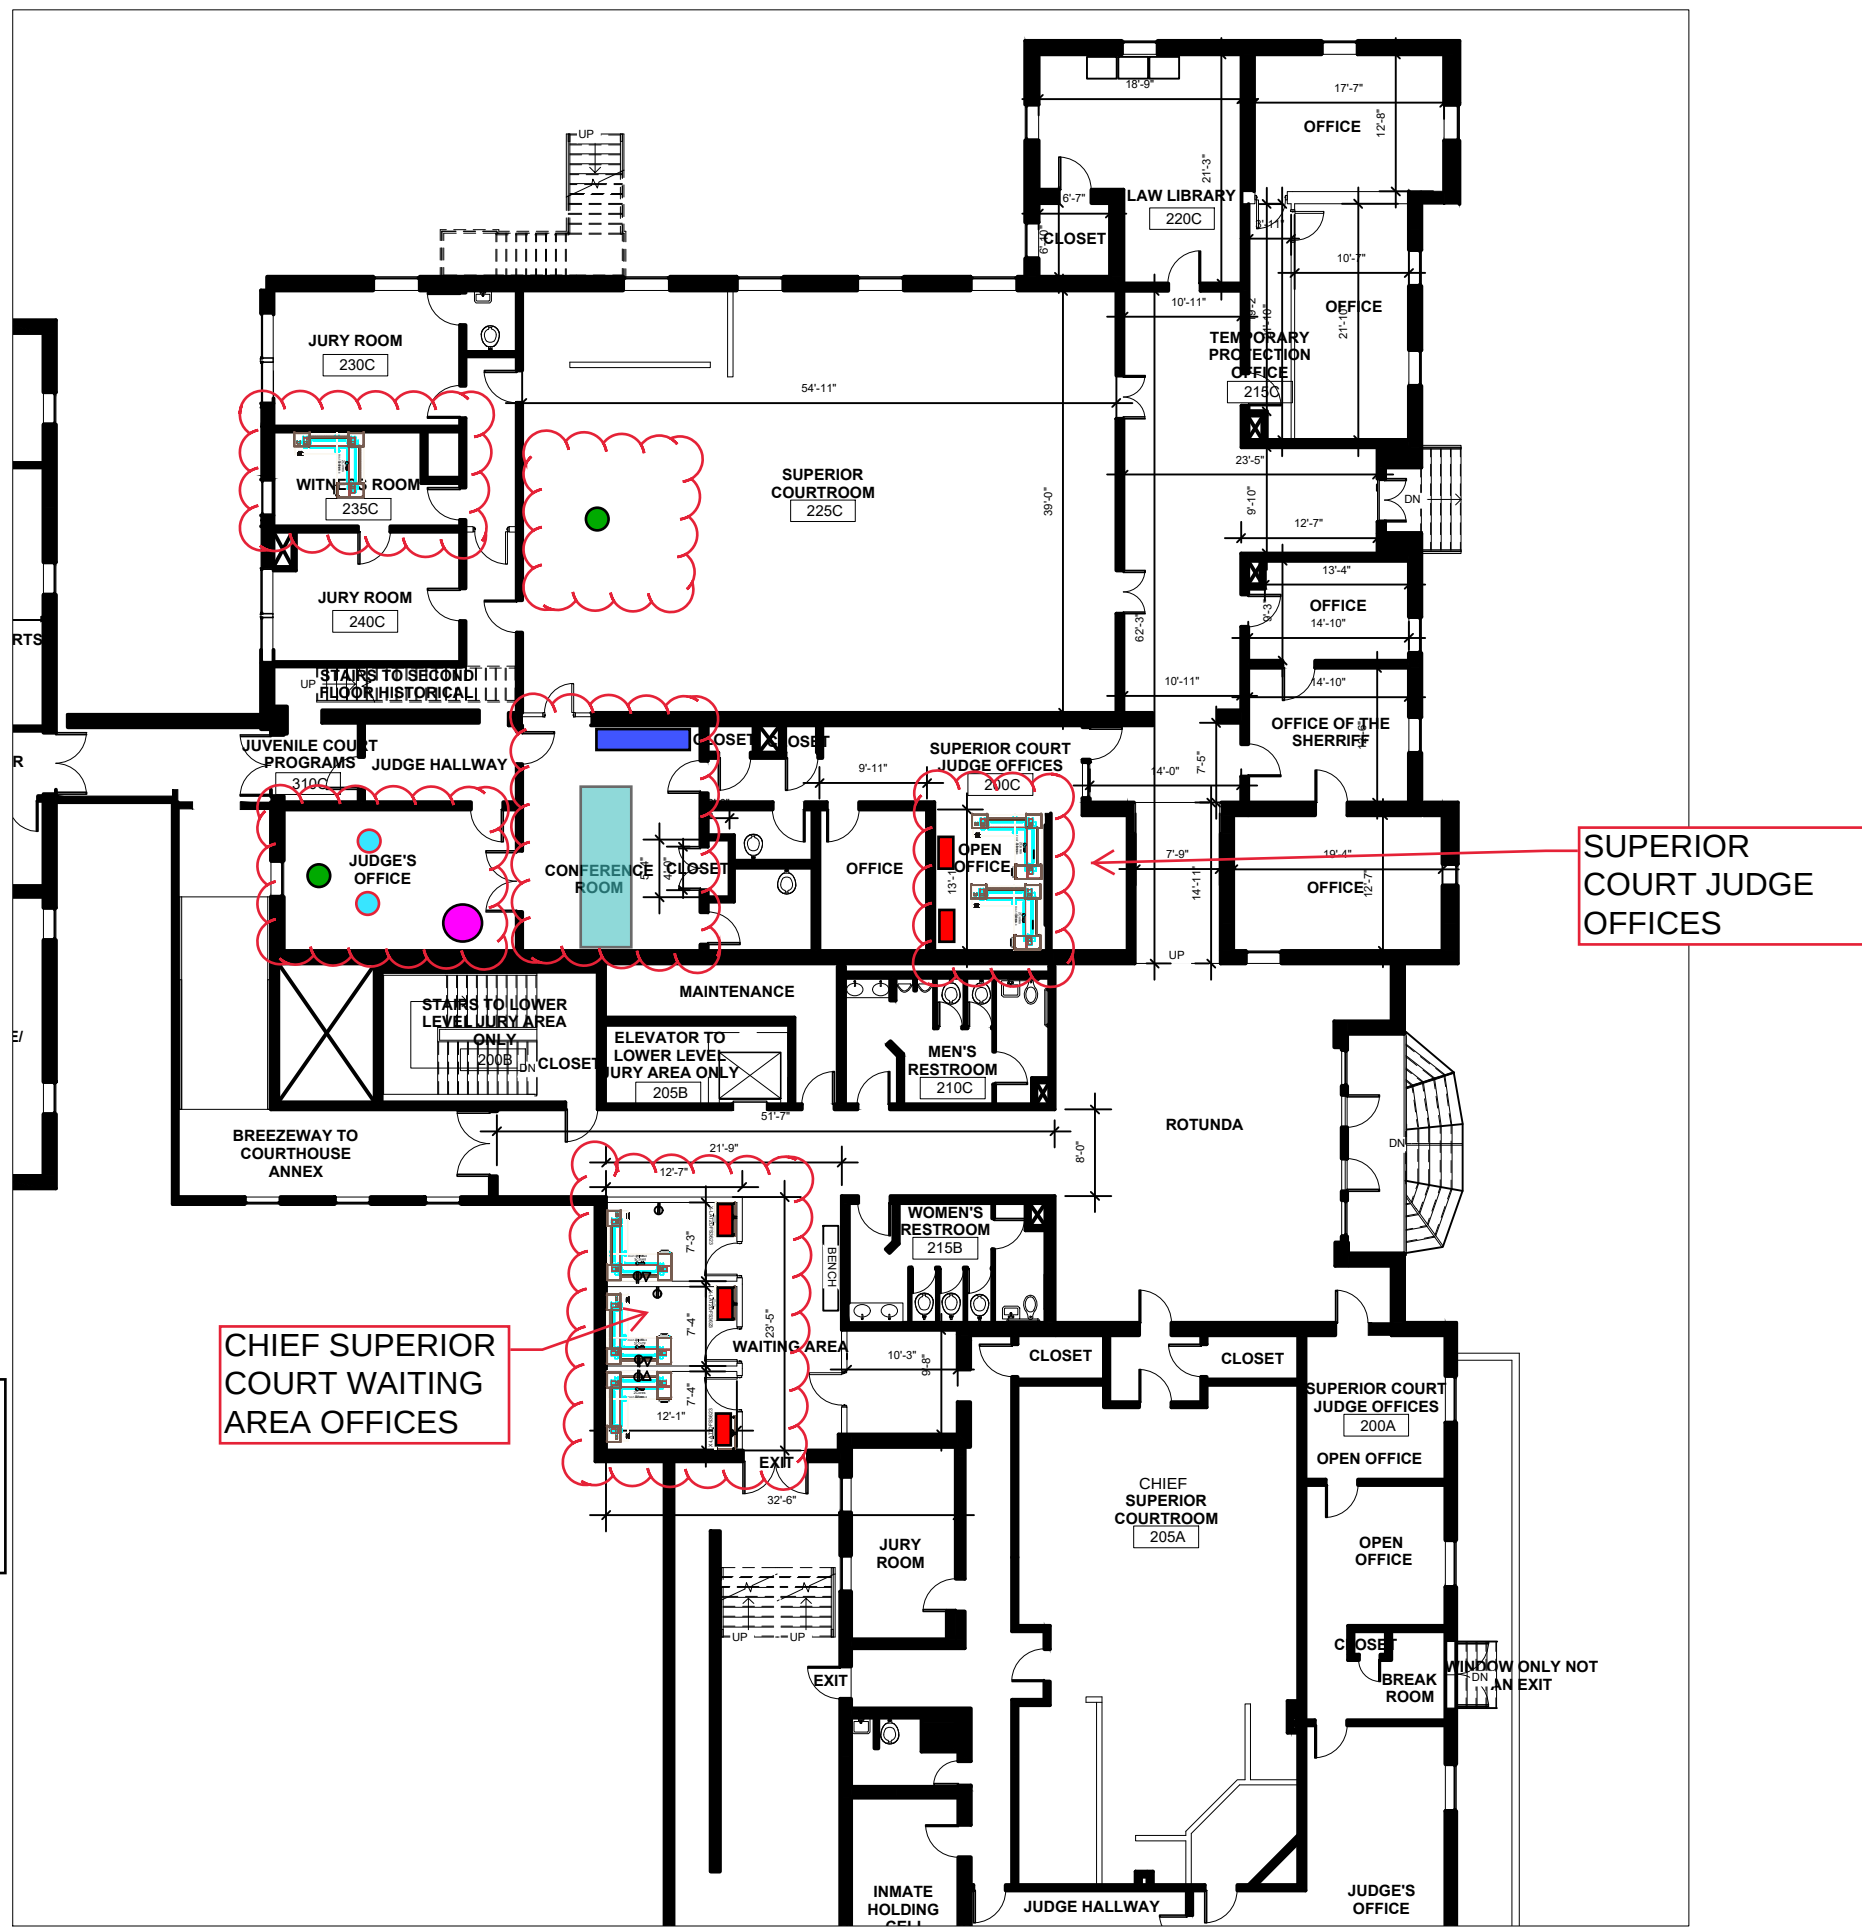

Rockdale County
Board of Commissioners
Department of General Services
PO BOX 289
CONYERS, GA 30012
PH: 770-278-7000



These drawings are the property of Rockdale County and shall not be used or reproduced without written permission.

Issue date/revisions

seal

EXHIBIT #2

project name
HISTORIC
COURTHOUSE
FURNITURE
922 COURT
STREET

sheet title
FIRST
FLOOR
HISTORICAL

drawn by B.KONOPKA	1H
checked by X	
project no. X	
date 8/13/2025	
scale NTS	sheet no.